


1

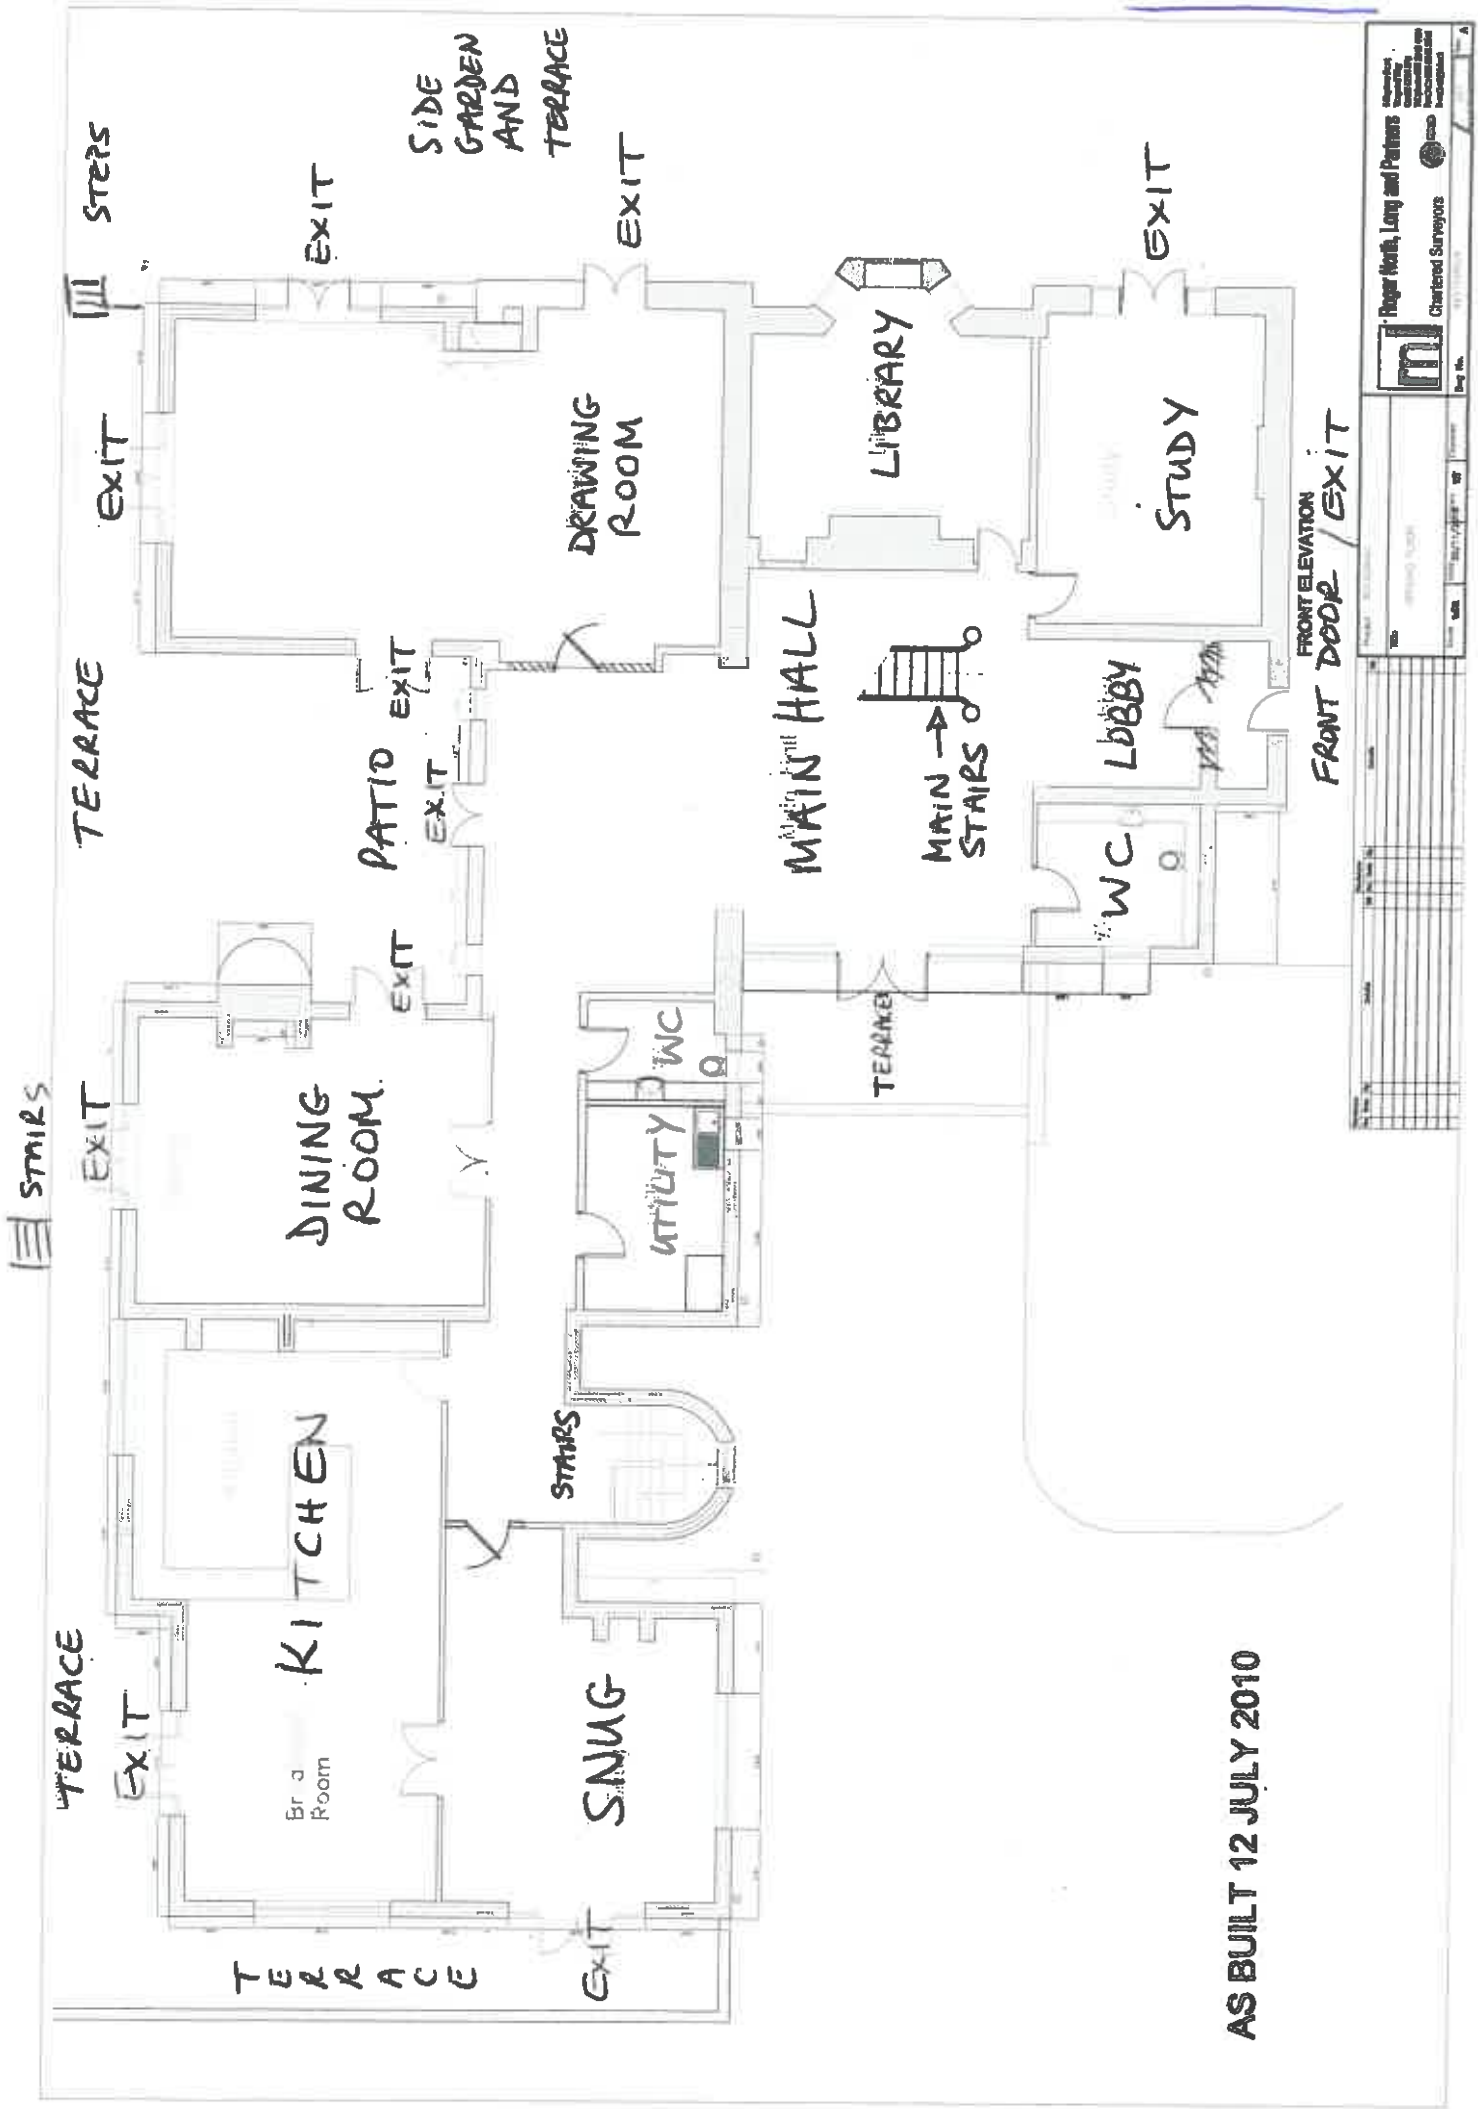

AS BUILT 12 JULY 2010

Project: []
 Date: []
 Scale: []
 Drawing No: []
 Drawing Title: []

Roger North, Long and Partners
 Chartered Surveyors

111 []
 []
 []
 []

EXIT GROUND LEVEL

BOILER ROOM

BED

BATH

BED

STAIRS

GARAGE

STORE


LOWER GROUND

CELLAR


EXIT

EXIT

AS BUILT 12 JULY 2010

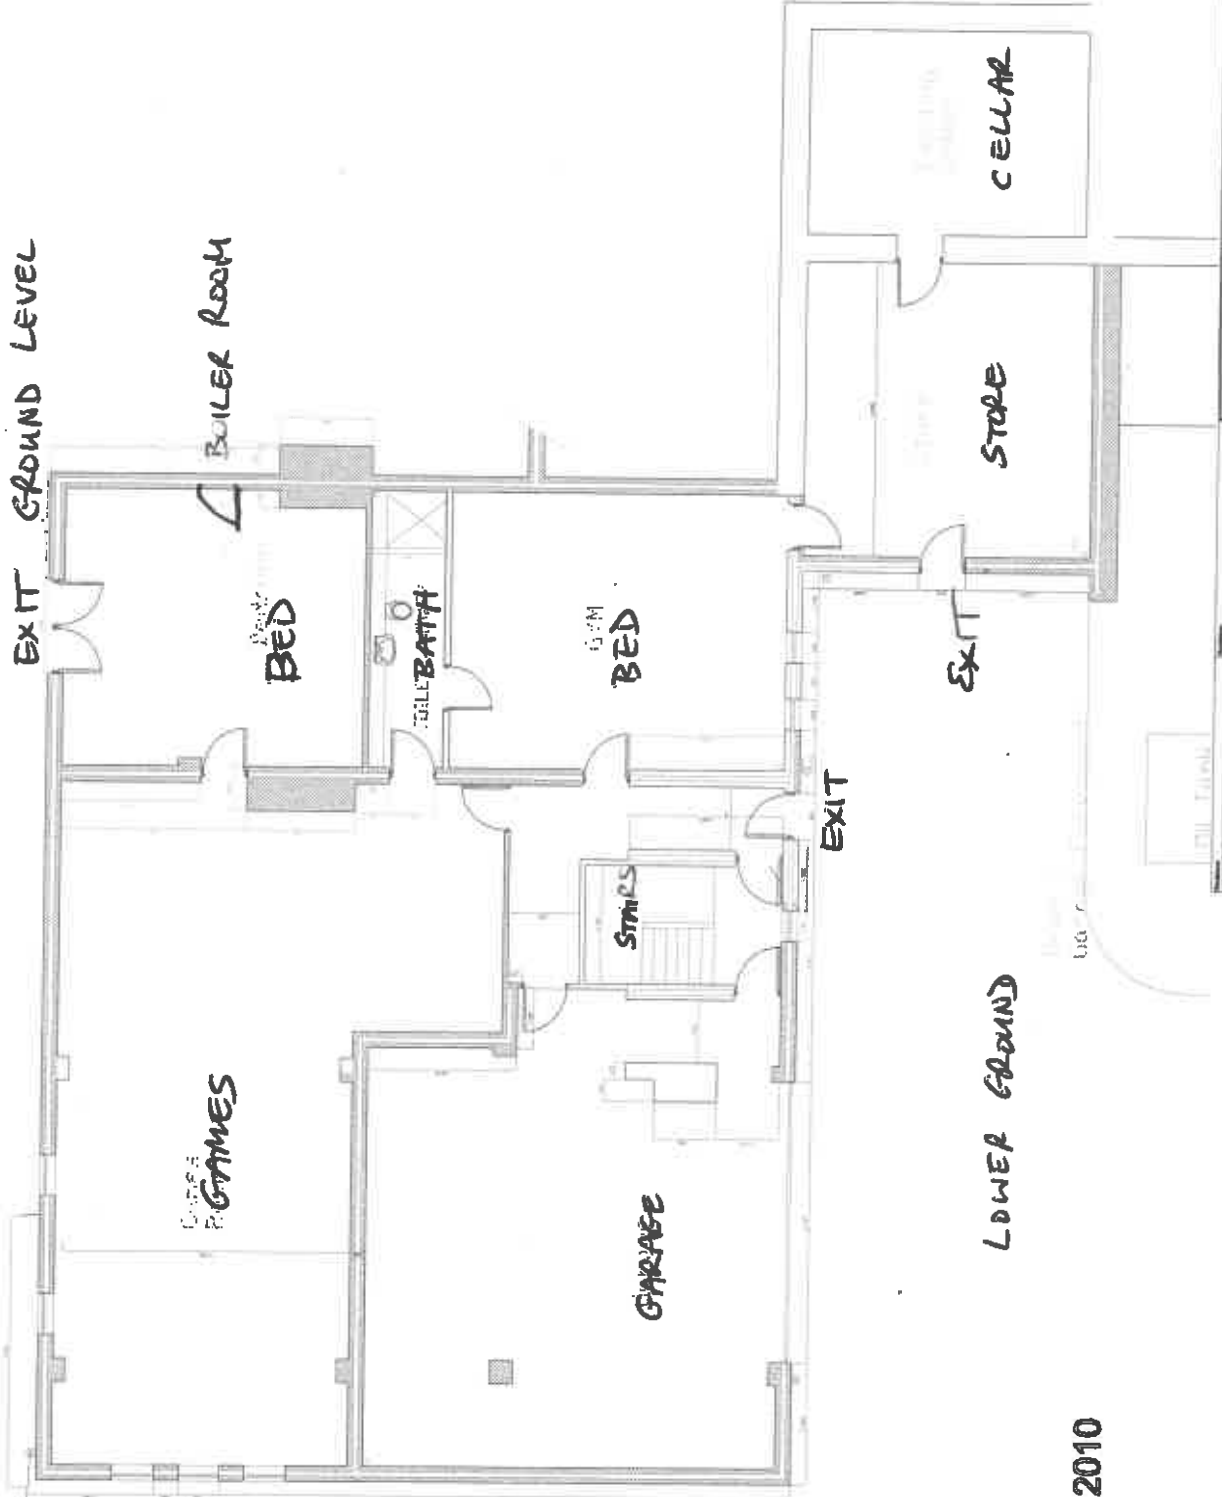

Project	
Title	
Client	
Date	
Scale	
Drawn	
Checked	
App'd	

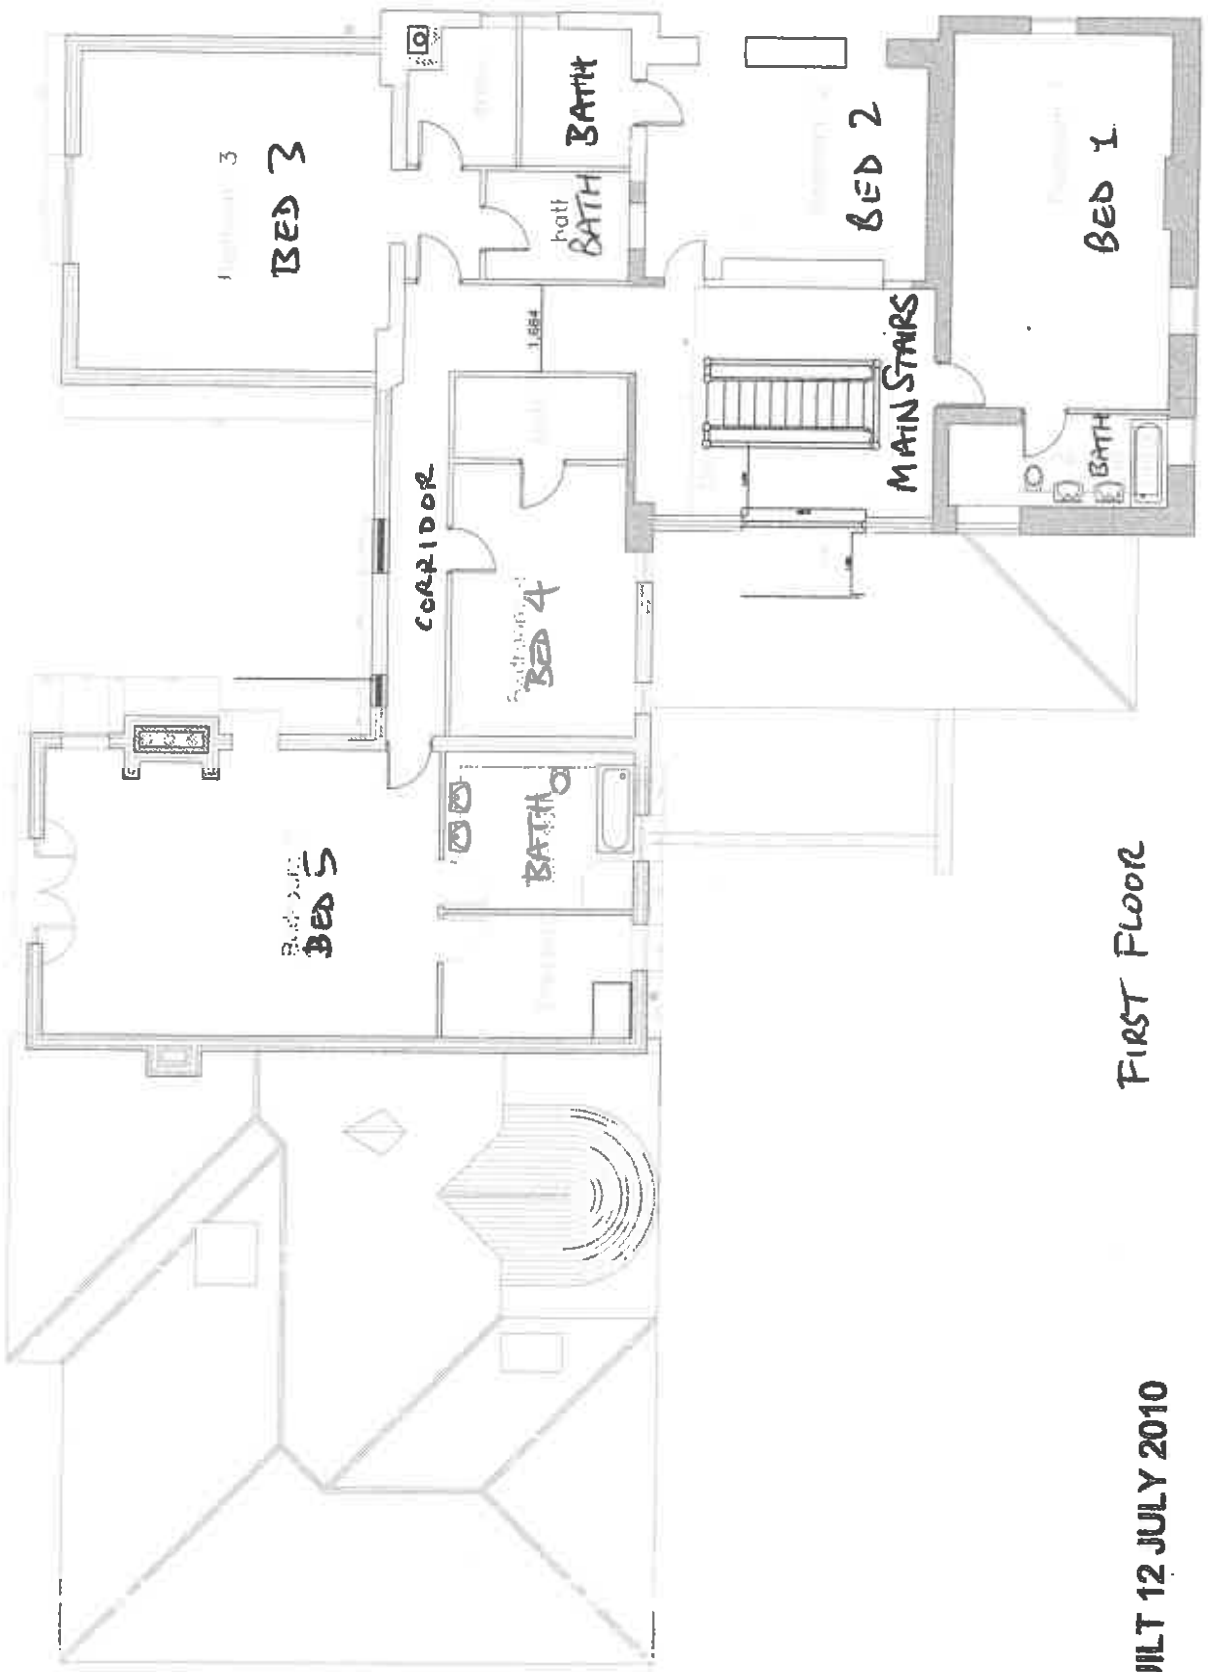

FIRST FLOOR

BUILT 12 JULY 2010

m
 Roger North, Long and Partners
 Chartered Surveyors
 0207099025

Project	1000
Site	1000
Scale	1:100
Date	12/07/10
Drawn by	...
Checked by	...
Project No.	...
Sheet No.	...